


EXAMPLE 1

The "5-STOP," no vehicles shown on plans, when vehicles try to parallel park between trees, other vehicles backup while waiting.

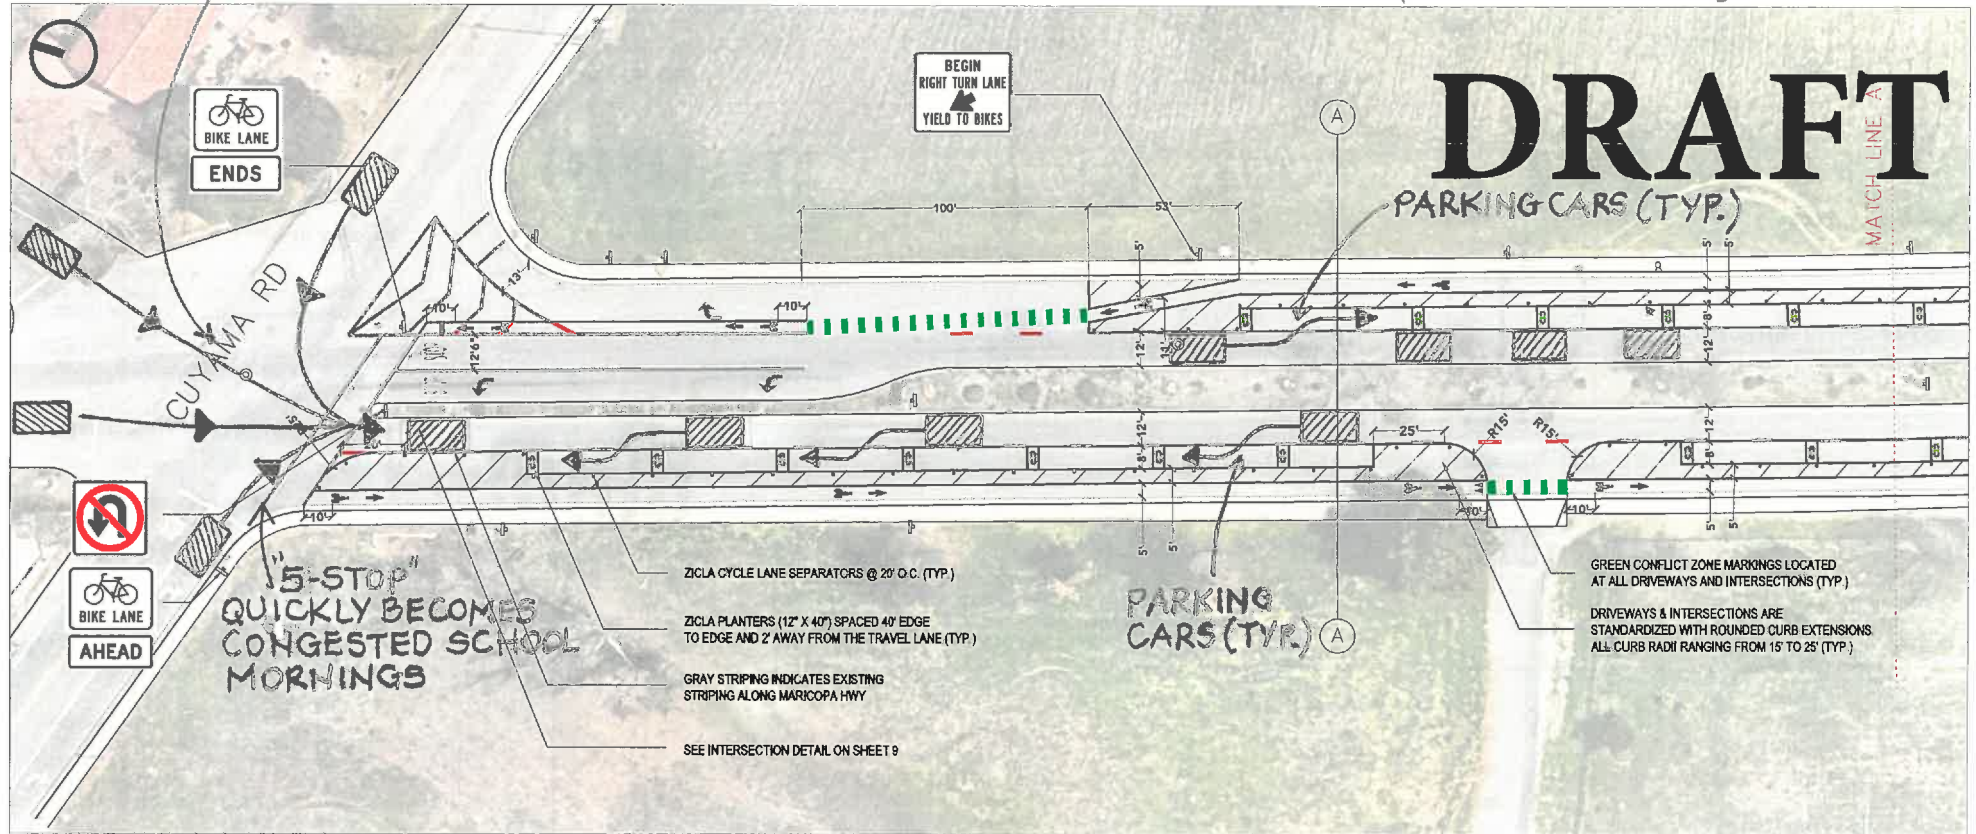

DEMONSTRATION PROJECT SITE PLAN

UTILITY LEGEND

	UTILITY LIGHT
	MANHOLE/SANITARY SEWER
	WATER VALVE
	CATCH BASIN
	FIRE HYDRANT
	EXISTING SIGN POLES

STREETPLANS

STREET PLANS INC.
 PLANNING - TRANSPORTATION - DESIGN - RESEARCH
 6870 SUNSET DRIVE, SUITE 4,
 SOUTH MIAMI, FL 33143
 305-676-6426 | STREETPLANS.ORG

S2 MARICOPA HWY STRIPING PLAN

DRAWING TITLE

04/07/2020	04/09/2020
REVIEW # 1	REVIEW # 2
06/03/2020	
SUBMISSION DATE	
1:20	
SCALE	

NOTES

- EXISTING STRIPING AND PAVEMENT MARKINGS ARE SHOWN IN GRAY. PAVEMENT MARKINGS THAT CONFLICT WITH PROPOSED BIKE LANE (SHOWN IN RED) TO BE REMOVED DURING DEMONSTRATION
- PROPOSED BIKE LANE MARKINGS SHOW IN BLACK, AND CONFLICT ZONE MARKINGS IN GREEN
- STRIPING: WHITE SHERWIN WILLIAMS HOTLINE PAINT
- DELINEATORS: ZICLA CYCLE LANE SEPARATOR, PLANTERS: ZICLA ZEBRA PLANTER (SEE PAGES 15-17)
- SIGNAGE: MUTCD SIGNS TO BE AFFIXED TO EXISTING POLES WHERE INDICATED, PROJECT BANNERS TO BE AFFIXED TO EXISTING LIGHT POLES WHERE INDICATED (SEE PAGE 16 FOR MORE DETAILS)

STREET SECTION 'A'

1/8" = 1'-0"

